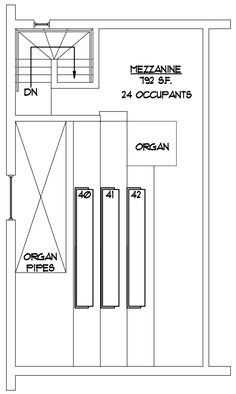

AS-BUILT
MEZZANINE FLOOR PLAN
SCALE: 1/8" = 1' - 0"

MEZZANINE FLOOR PLAN S.F. = 792 S.F.
(INSIDE WALL LINES)

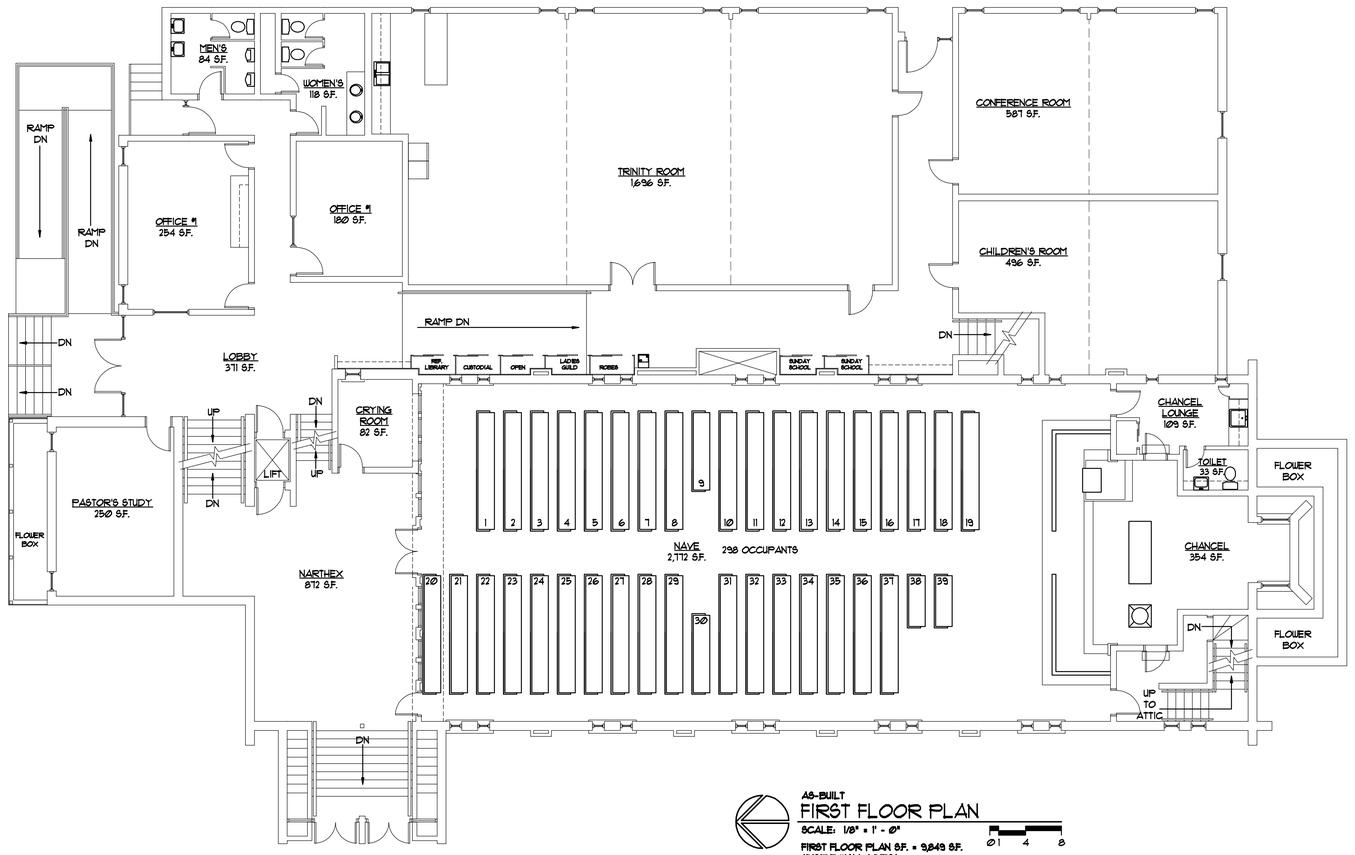

AS-BUILT
FIRST FLOOR PLAN
SCALE: 1/8" = 1' - 0"

FIRST FLOOR PLAN S.F. = 9,849 S.F.
(INSIDE WALL LINES)

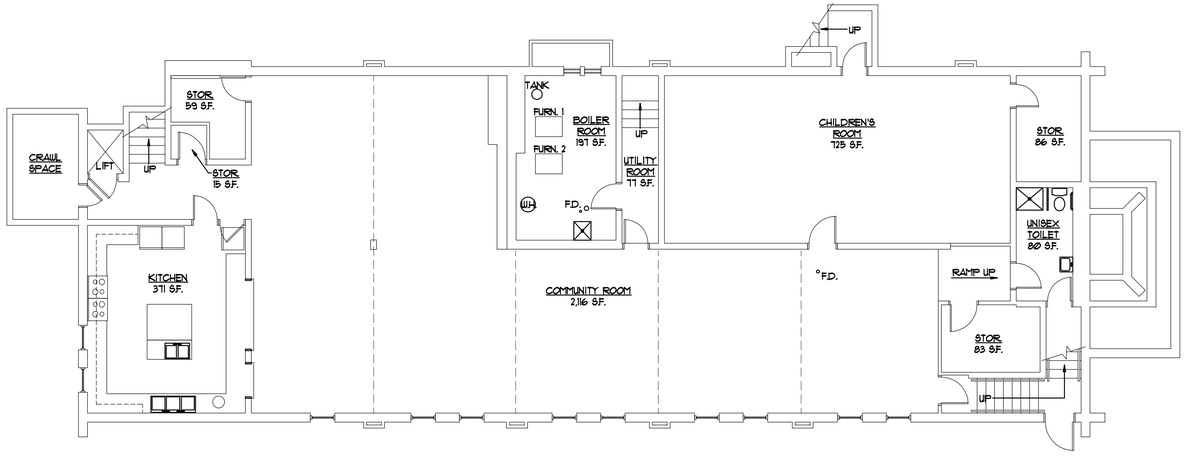

AS-BUILT
LOWER LEVEL FLOOR PLAN
SCALE: 1/8" = 1' - 0"

LOWER LEVEL FLOOR PLAN S.F. = 4,134 S.F.
(INSIDE WALL LINES)

GAZALL, LEWIS & ASSOCIATES ARCHITECTS, INC.
MOTT FOUNDATION BUILDING
503 SOUTH SAGINAW STREET SUITE 100
FLINT, MICHIGAN 48502
• PHONE (810) 239-4691
• FAX (810) 239-5191
• GL@GAZALL-LEWIS.COM
• WWW.GAZALL-LEWIS.COM

DRAWN	CHECKED	REVISED DATE	DATE
CTC	JRG		JANUARY 15, 2013

REVISIONS

Jan 17, 2013 - 9:08am

AS-BUILT FLOOR PLANS FOR:
TRINITY LUTHERAN CHURCH
706 WEST FLINT STREET DAVISON, MI 48423

COMMISSION
1264

SHEET
A1.1

X:\1264 TRINITY LUTHERAN CHURCH\1264 AFP.dwg